




deHAVILLAND

NOTE 1 CHANGED
.016 R $\pm .016$ / - .000 ADDED
WAS R .090. NOW R .090 $\pm .016$
90° 0' $\pm 1^\circ$ ADDED

A P

RLM RFG

20 Oct 93

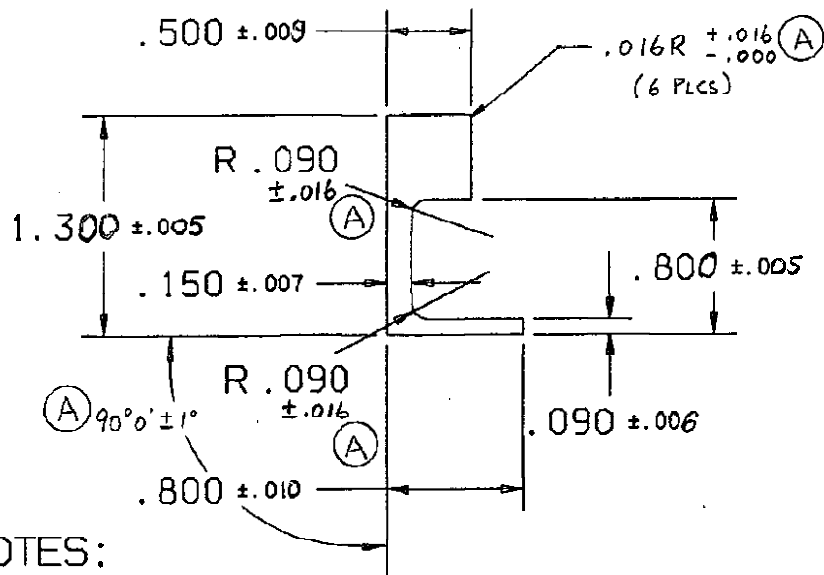

NOTES:

- (A) 1. ~~EXTERNAL CORNERS .016 RAD~~ TOLERANCES TO
~~UNLESS SPECIFIED. FED. STD. 245 UNLESS OTHERWISE SPECIFIED.~~
2. MAT'L AL. ALLOY 7150
AMS 4345 TEMPER T77511.
3. MIN. LENGTH 21 FT.

DRAWN:	M. MARCUCCI	CLASSIFICATION	STANDARD
DATE:	93/06/25		
CHECKED:	<i>[Signature]</i>	EXTRUDED SHAPE	CV713
STRESS:	<i>[Signature]</i>		
APPROVED:	<i>[Signature]</i>		

LEARN HAS - TOP & BTM SKINS STRS, O/WING