


This drawing is private and confidential and is supplied on the express condition that it is not to be used for any purpose or copied or communicated to any other person without the permission of THE DE HAVILLAND AIRCRAFT OF CANADA LIMITED

REPORT ALL DRAWING ERRORS TO ENGINEERING



REVISIONS

CHANGE	ITEM NO.	DESCRIPTION	DATE	DRAWN	CHECKED	STRESS	APPROVD.
A		ALTERED-IDENT OF CIRCUIT DIAGRAM B ₂ WAS B ₃	27 JUN 66	EVP	W.H. McKEOWN		B.C.B.

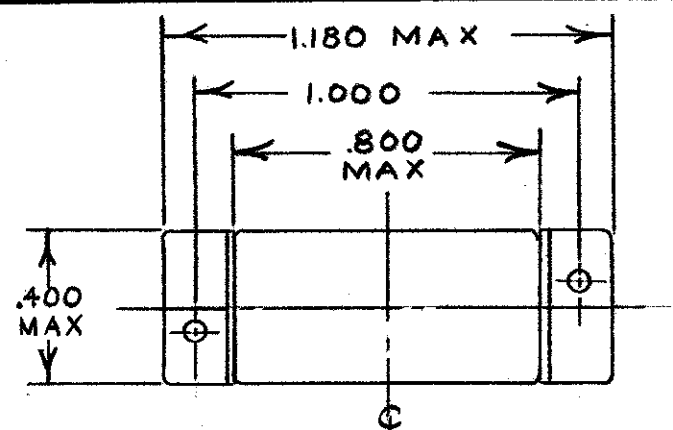


NOTES

- 1 DSC 36-1 RELAY SHALL CONFORM TO MIL-R-5757/10
2. EACH RELAY SHALL BE TESTED FOR DRY CIRCUIT OPERATION BY THE MANUFACTURER PRIOR TO SHIPMENT. THERE SHALL BE NO 'MISSES' DURING 5000 OPERATIONS AT NOMINAL COIL VOLTAGE AND ROOM TEMPERATURE.
3. TERMINAL IDENT'S ARE REF ONLY AND DO NOT NECESSARILY APPEAR ON THE RELAY.

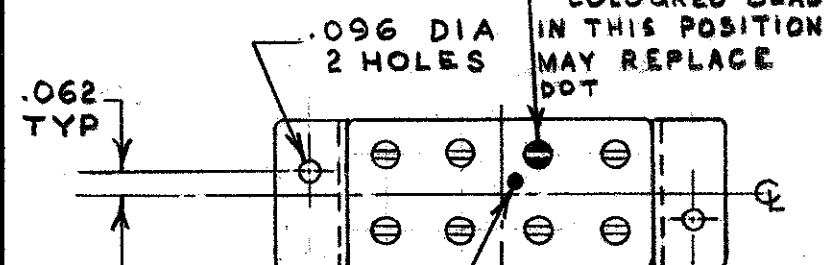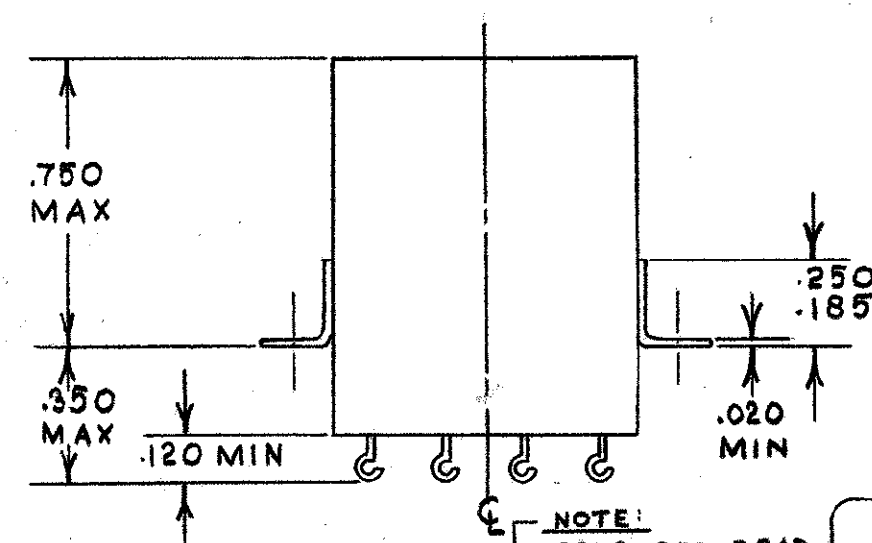

NOTE:
COLOURED BEAD
IN THIS POSITION
MAY REPLACE
DOT

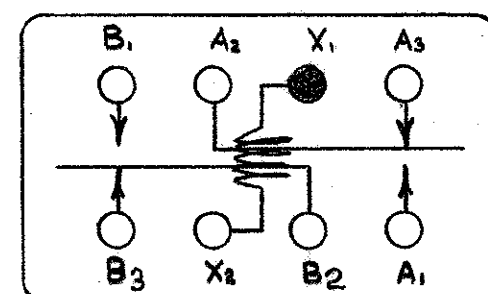

CIRCUIT DIAGRAM
UNENERGIZED POSITION

COLOURED LINE OR
DOT IN THIS POSITION

SOURCE CONTROL DRAWING

ONLY THE ITEM(S) LISTED ON THIS DRAWING AND IDENTIFIED BY VENDOR'S NAME(S), ADDRESS(ES) AND PART NUMBER(S) HAVE BEEN APPROVED BY THE DE HAVILLAND AIRCRAFT OF CANADA LIMITED FOR THE USE IN DHC AIRCRAFT. A SUBSTITUTE ITEM SHALL NOT BE USED WITHOUT PRIOR APPROVAL BY THE DE HAVILLAND AIRCRAFT OF CANADA LTD.

MOD NO.	E.O. 7171	THE DE HAVILLAND AIRCRAFT OF CANADA LIMITED DOWNSVIEW ONTARIO					
DRAWN	C.L. BECSY 20 APR 66	DRAWING TITLE					
CHECKED	W.H. McKEOWN	RELAY 2AMP 2PDT					
APPROVED	B.C. BEASLEY						
STRESS							
		CODE IDENT NO.	DWG SIZE	DRAWING NO.	RELEASE	REV.	
		71867	B	DSC 36		A	
		SCALE 2:1	WGT. CALC	ACTUAL	SHEET	1 of 2	

This drawing is private and confidential and is supplied on the express condition that it is not to be used for any purpose or copied or communicated to any other person without the permission of THE DE HAVILLAND AIRCRAFT OF CANADA LIMITED

REPORT ALL DRAWING ERRORS
TO ENGINEERING

REVISIONS

CHANGE	ITEM NO.	DESCRIPTION	DATE	DRAWN	CHECKED	STRESS	APPROV.
A		NO.5 VENDOR ADDED	18 MAY 66	C. BEASLEY	H. H. H.		B.C.B.
B		NO.6 VENDOR ADDED	24 JUN 66	POLISTON			B.C.B.
C		NO.7 VENDOR ADDED	4 JAN 67	E. ALSTON			B.C.B.
D		ALTERED- HI-G INC. PART No. 2B-3103 REPLACES P/N 2B-1506. (VENDOR 2)	14/12/67	R. G. L.			B.C.B.
E	I	DELETED- VENDOR NO. 1	19/1/68	R. G. L.			B.C.B.
F		ADDED P/N 79GB2N-4-AA-600 (1) TO VENDOR NO. 5	12/12/68	O. R.			B.C.B.
G		ALTERED: P/N RP-9817-G25 WAS RP-9817-G5 AT VENDOR NO. A	26-2-69	O. R.			B.C.B.
H		#3 VENDOR WAS FILTERS INC., PORT WASHINGTON, NEW YORK, USA. & IN CANADA, MARSLAND ENG. LTD., WATERLOO, ONTARIO.	28-4-70	TUNNEY			B.C.B.

△ UNION SWITCH and SIGNAL DIVISION, WESTINGHOUSE AIR BRAKE Co:

PITTSBURGH, PA, USA. FSC 61775

△ BABCOCK RELAYS, COSTA MESA, CALIF, USA. FSC 09026

△ ELECTRONIC SPECIALTY CO., PORTLAND, OREGON., USA. FSC 20019

△ C.P. CLARE & CO. CHICAGO, ILL, USA. FSC 71482
IN CANADA:

C.P. CLARE CANADA LTD., 61 INDUSTRY ST. TORONTO 15, ONT,

△ DEUTSCH RELAY DIVISION, 65 DALY ROAD,
EAST NORTHPORT, NEW YORK, U.S.A. FSC 99699

△ HI-G INC., WINDSOR LOCKS, CONN, USA. FSC 02289

△ ~~LEACH CORP, LOS ANGELES, CALIF, USA FSC 35344~~

VENDORS ADDRESS

SOURCE CONTROL DRAWING

ONLY THE ITEM(S) LISTED ON THIS DRAWING AND IDENTIFIED BY VENDOR'S NAME(S), ADDRESS (ES) AND PART NUMBER(S) HAVE BEEN APPROVED BY THE DE HAVILLAND AIRCRAFT OF CANADA LIMITED FOR THE USE IN DHC AIRCRAFT. A SUBSTITUTE ITEM SHALL NOT BE USED WITHOUT PRIOR APPROVAL BY THE DE HAVILLAND AIRCRAFT OF CANADA LTD.

MOD NO.	E0.7171	THE DE HAVILLAND AIRCRAFT OF CANADA LIMITED DOWNSVIEW ONTARIO				
DRAWN	W GARDEN 25 APR 66	DRAWING TITLE				
CHECKED	W H H. H. H.	RELAY 2 AMP 2 PDT				
APPROVED	B.C. BEASLEY					
STRESS						
		CODE IDENT NO.	DWG SIZE	DRAWING NO.	RELEASE	REV.
		71867	B	DSC 36		H
		SCALE	WGT. CALC	ACTUAL	SHEET 2 OF 2	